

Name of Work: Package - 7 Consists of 7 Works

DRAWING SHEETS

"THIRD AND PART BILL"

7th Block HMT Layout

Last bus stop to GKV Layout

GKV Rd

9th Cross Rd
L-97.70m

8th Cross Rd
RHS L-39.30m
L-107.00m
LHS L-34.50m

7th Cross Rd
LHS L-69.10m
L-172.90m
RHS L-68.20m

6th Cross Rd

2nd Cross Rd

1st B Cross Rd

3rd Cross Rd
L-200.40m
L-100.00m

11th Cross Rd

6th Cross Rd


Vidyananyapura Bus stand

vidyananyapura BBMP subdivision office Road

6th Block BEL Layout

6th Block HMT Layout

Legend:
 - Green line: 7th Block HMT Layout
 - Red line: 6th Block BEL Layout
 - Blue line: 6th Block HMT Layout

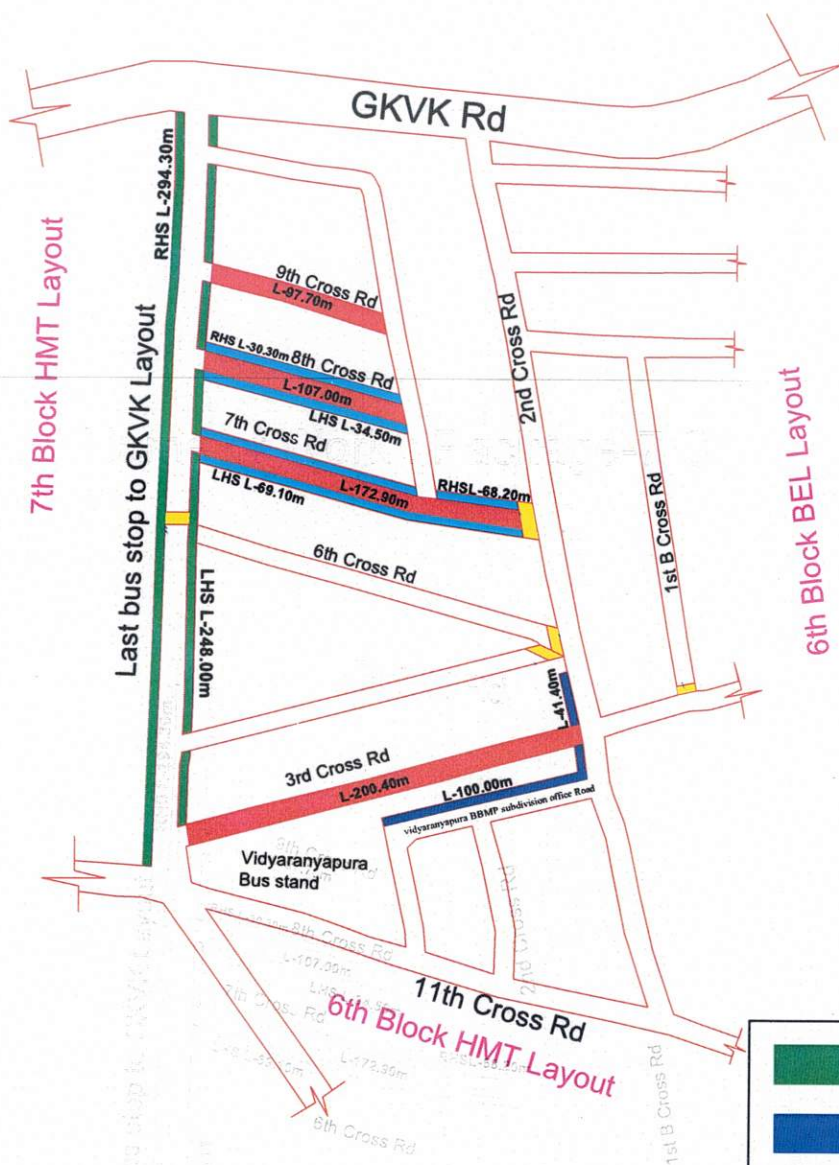

- | | |
|--|-----------------|
|  | DESILT |
|  | RCC DRAIN |
|  | ASPHALT ROAD |
|  | CULVERT |
|  | FLAGGING COARSE |

Assistant Engineer


Asst. Executive Engineer

Assistant Executive Engineer

Vidyaranyapura Sub Division

B.B.M.P, Bangalore - 97


Name of Work : Package-7 Consists of 7 Works

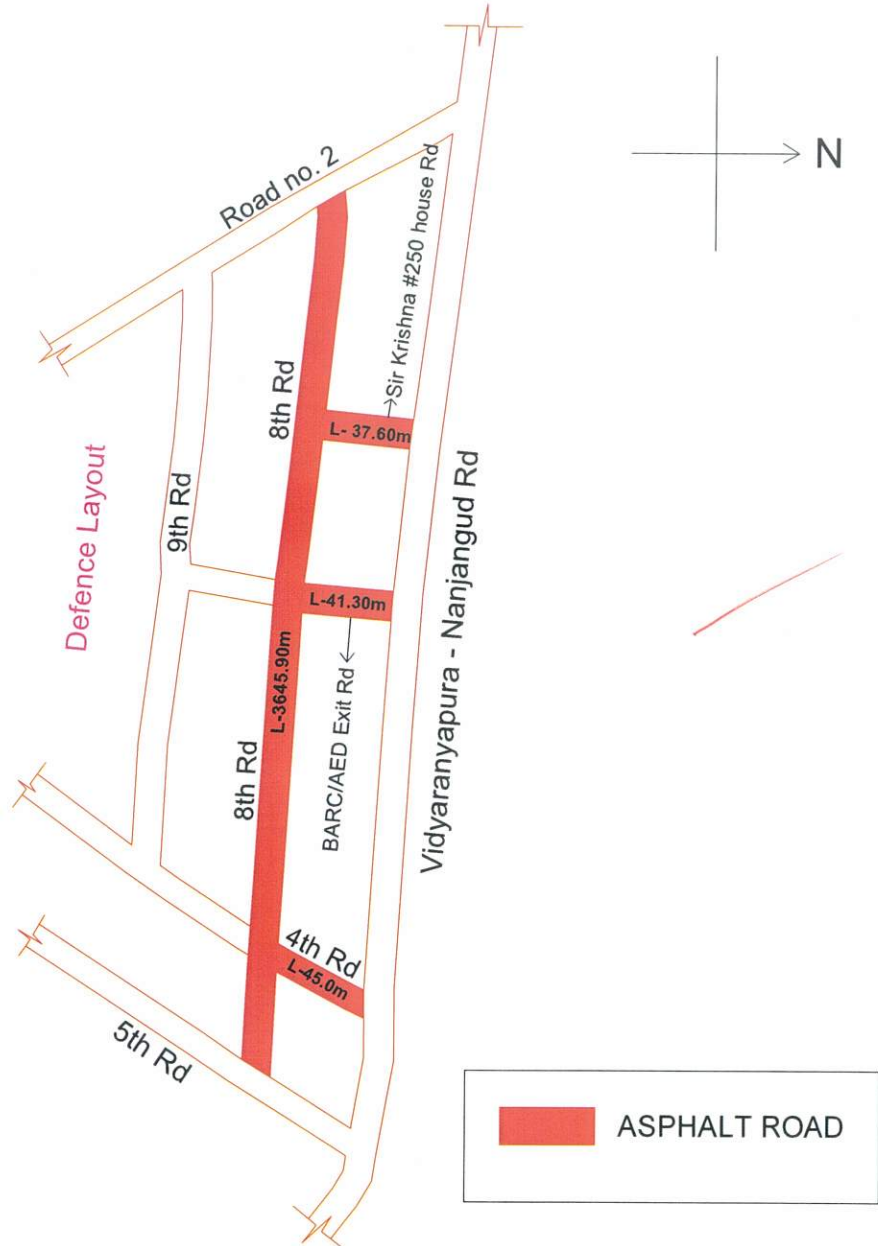

Assistant Engineer

Asst. Executive Engineer
Assistant Executive Engineer
Vidyaranyapura Sub Division
B.B.M.P, Bangalore - 97

Name of Work : Package-7 Consists of 7 Works

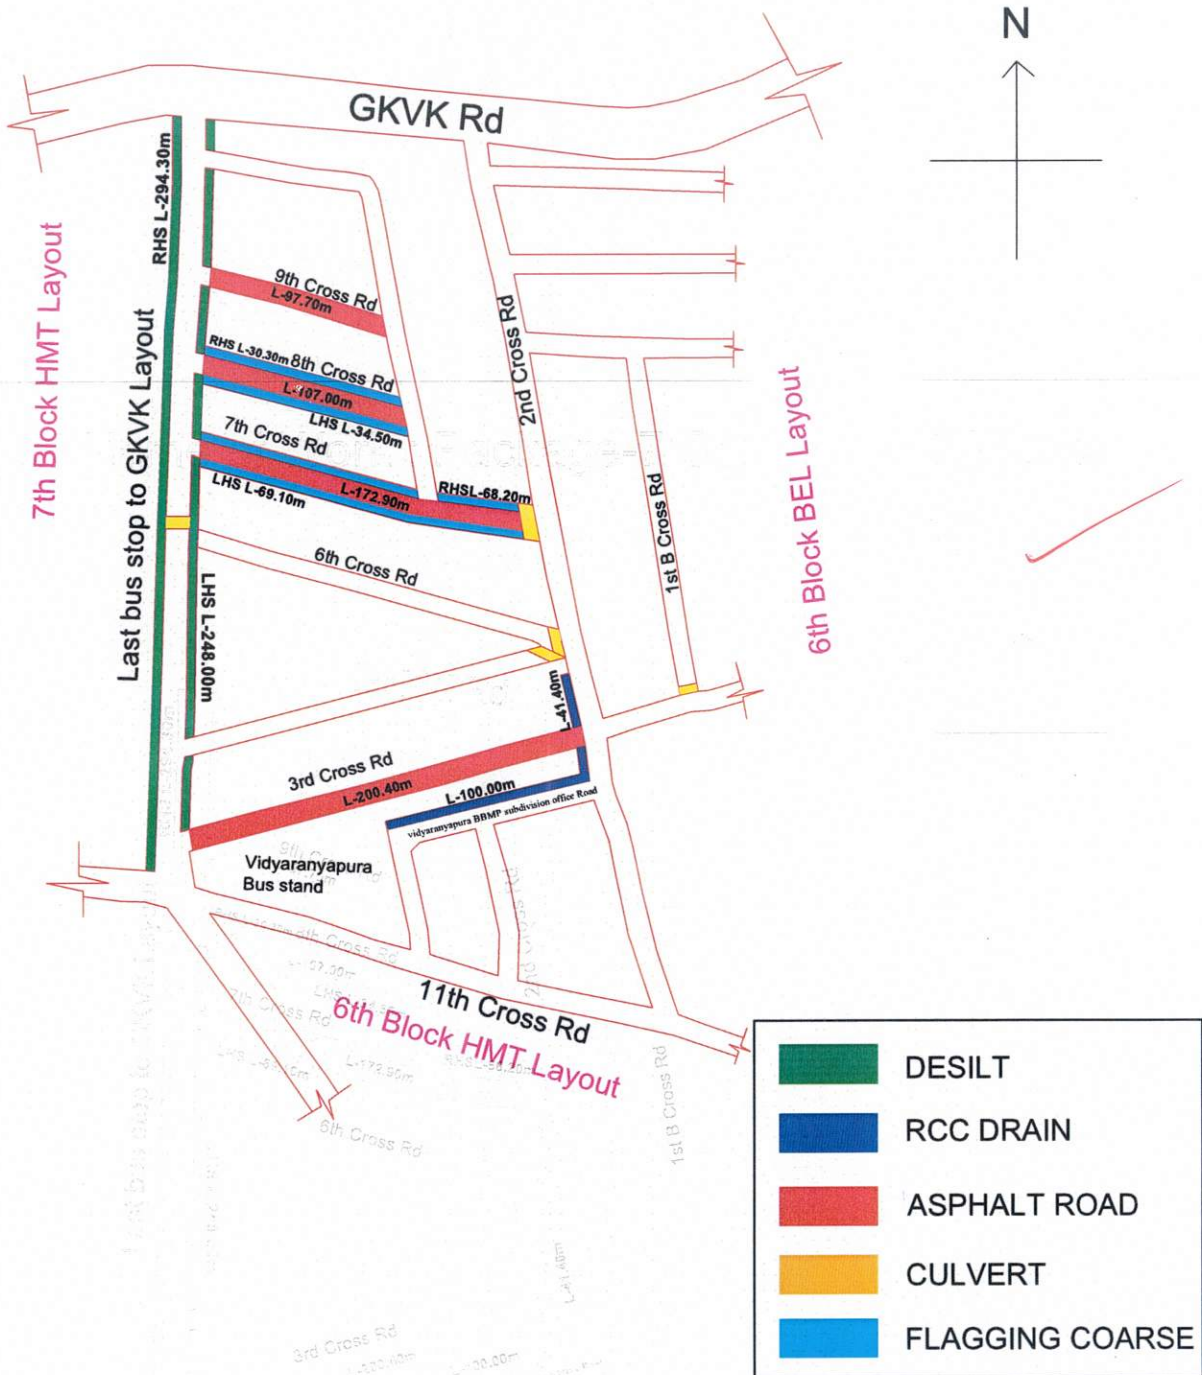

K. Lueg
Contractor

Consultant

Assistant Engineer

Asst. Executive Engineer
Assistant Executive Engineer
Vidyaranya Sub Division
B.B.M.P, Bangalore - 97